

# Work Order ID 135113

\*135113\*

Page 1

July 29, 2015 11:00:47 AM

Item ID: D407-667-105TRN

Accept

\*N900040100\*

Setup Start \*NS1\*

Revision ID:

Stop \*NS2\*

Item Name: Crosstube Turning Detail

Start Date: 7/29/2015 Start Qty: 1.00 \*1\*

Cust Item ID:

Required Date: 8/12/2015 Req'd Qty: 1.00 \*1\*

Customer:

Reference:

Approvals: Process Plan: SH Date: 20150729

Tooling:

Date:

Run Start \*NR1\*

QC:

Date:

SPC (Y/N):

Date:

Stop \*NR2\*

| Sequence ID/<br>Work Center ID | Operation<br>Description | Set Up/<br>Run Hours | Tool ID | Tool # | Plan<br>Code | Accept<br>Qty | Reject<br>Qty | Reject<br>Number | Insp.<br>Stamp |
|--------------------------------|--------------------------|----------------------|---------|--------|--------------|---------------|---------------|------------------|----------------|
|--------------------------------|--------------------------|----------------------|---------|--------|--------------|---------------|---------------|------------------|----------------|

| Draw Nbr | Revision Nbr |
|----------|--------------|
|----------|--------------|

|              |       |
|--------------|-------|
| D407-667-145 | Rev C |
|--------------|-------|

100

0.00

\*100\*

MORI SEIKI CNC LATHE LARGE

Mori Seiki

Memo

0.00

Mori Seiki CNC Lathe Large

1-Fill tube with sand & install plugs DT8673 on both ends as per Folio FA249

2-Turn first side as per Folio FA249

3-Blend transition lines only, \*\*do not sand whole tube\*\*:

FOLIO REV: AD

DWG REV: C

\*Use mill bastard file, brush file repeatedly with file card.

\*Do not use sandpaper coarser than 320 grit.

110

QC1- Inspection performed by CMM

0.00

\*110\*

QC

Memo

0.00

Quality Control

1 0

mml  
15/07/30

1 0

mml  
15/07/30

DQA: \_\_\_\_\_ Date: \_\_\_\_\_



## WORK ORDER NON-CONFORMANCE / UPDATE

QA Closed: \_\_\_\_\_ Date: \_\_\_\_\_

Work Order update only ☐

|                                                              |                                                |   |                                                            |   |                                               |  |                       |                                                 |  |
|--------------------------------------------------------------|------------------------------------------------|---|------------------------------------------------------------|---|-----------------------------------------------|--|-----------------------|-------------------------------------------------|--|
| Work Order: _____<br><br>Part No. _____<br><br>NCR No. _____ |                                                | <b>DISPOSITION</b><br><br>Rework <input type="checkbox"/><br>Scrap <input type="checkbox"/><br>Use-as-is <input type="checkbox"/><br>Suspected Unapproved <input type="checkbox"/> |                                                            | <b>AGAINST DEPARTMENT/PROCESS</b><br><br><div style="display: flex; justify-content: space-between;"> <div>           Skid-tube <input type="checkbox"/><br/>           Machining <input type="checkbox"/><br/>           Thermoforming <input type="checkbox"/><br/>           Large Fab <input type="checkbox"/> </div> <div>           Cross tube <input type="checkbox"/><br/>           Small Fab <input type="checkbox"/><br/>           Finishing <input type="checkbox"/><br/>           Composite <input type="checkbox"/> </div> <div>           Water Jet <input type="checkbox"/><br/>           Prod. Eng. Coord. <input type="checkbox"/><br/>           Rec/Store/Packaging <input type="checkbox"/><br/>           Supplier <input type="checkbox"/> </div> <div>           Engineering <input type="checkbox"/><br/>           Quality <input type="checkbox"/><br/>           Other <input type="checkbox"/> </div> </div> |                                               |  |                       |                                                 |  |
| Date :                                                       |                                                | Step #:   |                                                            | QTY Effective :   |                                               |  | MRB (QSI042) Approval |                                                 |  |
| Description Work Order Deviation                             |                                                |   |                                                            | Disposition   |                                               |  |                       | Completed By                                    |  |
|                                                              |                                                |   |                                                            |   |                                               |  |                       | Lead hand / Supervisor<br>Approval Verification |  |
|                                                              |                                                |   |                                                            |   |                                               |  |                       | QC / QA Coordinator<br>Approval                 |  |
|                                                              |                                                |   |                                                            |   |                                               |  |                       |                                                 |  |
| <b>Root Cause</b>                                            |                                                | <b>FAULT CATEGORY</b>   |                                                            |   |                                               |  |                       |                                                 |  |
| Environment <input type="checkbox"/>                         | No Re-verification <input type="checkbox"/>    | Pressure/Forced <input type="checkbox"/>   | Temperature/Cure <input type="checkbox"/>                  | Power Loss/Surge <input type="checkbox"/>   | Positioned Wrong <input type="checkbox"/>     |  |                       |                                                 |  |
| Design <input type="checkbox"/>                              | Operator <input type="checkbox"/>              | Bending <input type="checkbox"/>   | Set-up <input type="checkbox"/>                            | Folio/Program <input type="checkbox"/>   | Outside Dimensions <input type="checkbox"/>   |  |                       |                                                 |  |
| Doc/Data <input type="checkbox"/>                            | Offset/Setup <input type="checkbox"/>          | Centre Not Concentric <input type="checkbox"/>   | BOM/Route <input type="checkbox"/>                         | Grain <input type="checkbox"/>   | Over/Under tolerance <input type="checkbox"/> |  |                       |                                                 |  |
| Equip/Tooling <input type="checkbox"/>                       | Supplier <input type="checkbox"/>              | Cracks <input type="checkbox"/>   | Broken/Damage/Defect <input type="checkbox"/>              | Weld <input type="checkbox"/>   | Part Incorrect <input type="checkbox"/>       |  |                       |                                                 |  |
| Handling/Pre <input type="checkbox"/>                        | Training <input type="checkbox"/>              | Crimp/Kink/Ripple/Wave <input type="checkbox"/>   | Inspection Incomplete/Unqualified <input type="checkbox"/> | Wrong Stock Pulled <input type="checkbox"/>   | Part Lost/Missing <input type="checkbox"/>    |  |                       |                                                 |  |
| Material <input type="checkbox"/>                            | Use for Testing <input type="checkbox"/>       | Cuffs <input type="checkbox"/>   | Contamination <input type="checkbox"/>                     | Out of Sequence <input type="checkbox"/>   | Part Moved <input type="checkbox"/>           |  |                       |                                                 |  |
| Internal Transport <input type="checkbox"/>                  | Poor Information <input type="checkbox"/>      | Crushing <input type="checkbox"/>   | Countersink <input type="checkbox"/>                       | Off-set <input type="checkbox"/>   | Drawing <input type="checkbox"/>              |  |                       |                                                 |  |
| Tribal Knowledge <input type="checkbox"/>                    | Rushing <input type="checkbox"/>               | Heat Treat <input type="checkbox"/>   | Cut Too Short <input type="checkbox"/>                     | Mislabeled <input type="checkbox"/>   | Finish <input type="checkbox"/>               |  |                       |                                                 |  |
| LOA <input type="checkbox"/>                                 | Product Improvement <input type="checkbox"/>   | Wave/Twist in Tube <input type="checkbox"/>   | Instructions Incomplete/Unclear <input type="checkbox"/>   | Fit/Function <input type="checkbox"/>   | Misread <input type="checkbox"/>              |  |                       |                                                 |  |
| Substation <input type="checkbox"/>                          | Process Improvement <input type="checkbox"/>   | Marks/Chatter <input type="checkbox"/>   | Drill Holes <input type="checkbox"/>                       | Misaligned/off center <input type="checkbox"/>   | Turning Sequence <input type="checkbox"/>     |  |                       |                                                 |  |
| Past Expiry Date <input type="checkbox"/>                    | Manufacturing Process <input type="checkbox"/> | OTHER :   |                                                            |   |                                               |  |                       |                                                 |  |
| Misidentified <input type="checkbox"/>                       | Past Due <input type="checkbox"/>              |   |                                                            |   |                                               |  |                       |                                                 |  |

**Work Order ID 135113****\*135113\***

Page 2

July 29, 2015 11:00:47 AM

Item ID: D407-667-105TRN

Accept

**\*N900040100\***Setup Start **\*NS1\***

Revision ID:

Stop **\*NS2\***

Item Name: Crosstube Turning Detail

Start Date: 7/29/2015 Start Qty: 1.00

**\*1\***

Cust Item ID:

Required Date: 8/12/2015 Req'd Qty: 1.00

**\*1\***

Customer:

Reference:

Approvals: Process Plan: \_\_\_\_\_ Date: \_\_\_\_\_ Tooling: \_\_\_\_\_ Date: \_\_\_\_\_

Run Start **\*NR1\***

QC: \_\_\_\_\_ Date: \_\_\_\_\_ SPC (Y/N): \_\_\_\_\_ Date: \_\_\_\_\_

Stop **\*NR2\***

| Sequence ID/<br>Work Center ID | Operation<br>Description | Set Up/<br>Run Hours | Tool ID | Tool # | Plan<br>Code | Accept<br>Qty | Reject<br>Qty | Reject<br>Number | Insp.<br>Stamp |
|--------------------------------|--------------------------|----------------------|---------|--------|--------------|---------------|---------------|------------------|----------------|
|--------------------------------|--------------------------|----------------------|---------|--------|--------------|---------------|---------------|------------------|----------------|

120

0.00

**\*120\***

MORI SEIKI CNC LATHE LARGE

Mori Seiki

Memo

0.00

Mori Seiki CNC Lathe Large

1-Turn second side as per Folio FA249

2-Blend transition lines only, \*\*do not sand whole tube\*\*:

\*Use mill bastard file, brush file repeatedly with file card.

\*Do not use sandpaper coarser than 320 grit.

FOLIO REV: MMDWG REV: C

3-Remove sand and plugs

4-Scribe part # and batch # using vibrating stylus as per Dwg D206-667-145  
inside of Cuff(Do not engrave on outside of tube)

1       $\phi$

mmL  
15/08/04

130

QC1- Inspection performed by CMM

0.00

**\*130\***

QC

Memo

0.00

Quality Control

1       $\phi$

mmL  
15/08/05

DQA: \_\_\_\_\_ Date: \_\_\_\_\_



## WORK ORDER NON-CONFORMANCE / UPDATE

QA Closed: \_\_\_\_\_ Date: \_\_\_\_\_

Work Order update only ☐

|   |   |   |   |   |   |               |                       |                                                 |  |
|---|---|---|---|---|---|---------------|-----------------------|-------------------------------------------------|--|
| Work Order: _____<br><br>Part No. _____<br><br>NCR No. _____   |   | <b>DISPOSITION</b><br><br>Rework <input type="checkbox"/><br>Scrap <input type="checkbox"/><br>Use-as-is <input type="checkbox"/><br>Suspected Unapproved <input type="checkbox"/>   |   | <b>AGAINST DEPARTMENT/PROCESS</b><br><br><div style="display: flex; justify-content: space-between;"> <div>             Skid-tube <input type="checkbox"/><br/>             Machining <input type="checkbox"/><br/>             Thermoforming <input type="checkbox"/><br/>             Large Fab <input type="checkbox"/> </div> <div>             Cross tube <input type="checkbox"/><br/>             Small Fab <input type="checkbox"/><br/>             Finishing <input type="checkbox"/><br/>             Composite <input type="checkbox"/> </div> <div>             Water Jet <input type="checkbox"/><br/>             Prod. Eng. Coord. <input type="checkbox"/><br/>             Rec/Store/Packaging <input type="checkbox"/><br/>             Supplier <input type="checkbox"/> </div> <div>             Engineering <input type="checkbox"/><br/>             Quality <input type="checkbox"/><br/>             Other <input type="checkbox"/> </div> </div> |   |               |                       |                                                 |  |
| Date :   |   | Step #:   |   | QTY Effective :   |   |               | MRB (QSI042) Approval |                                                 |  |
| Description Work Order Deviation   |   |   |   | Disposition   |   |               |                       | Completed By                                    |  |
|   |   |   |   |   |   |               |                       | Lead hand / Supervisor<br>Approval Verification |  |
|   |   |   |   |   |   |               |                       | QC / QA Coordinator<br>Approval                 |  |
|   |   |   |   |   |   |               |                       |                                                 |  |
| Root Cause   |   | FAULT CATEGORY   |   |   |   |               |                       |                                                 |  |
| Environment <input type="checkbox"/><br>Design <input type="checkbox"/><br>Doc/Data <input type="checkbox"/><br>Equip/Tooling <input type="checkbox"/><br>Handling/Pre <input type="checkbox"/><br>Material <input type="checkbox"/><br>Internal Transport <input type="checkbox"/><br>Tribal Knowledge <input type="checkbox"/><br>LOA <input type="checkbox"/><br>Substation <input type="checkbox"/><br>Past Expiry Date <input type="checkbox"/><br>Misidentified <input type="checkbox"/> | No Re-verification <input type="checkbox"/><br>Operator <input type="checkbox"/><br>Offset/Setup <input type="checkbox"/><br>Supplier <input type="checkbox"/><br>Training <input type="checkbox"/><br>Use for Testing <input type="checkbox"/><br>Poor Information <input type="checkbox"/><br>Rushing <input type="checkbox"/><br>Product Improvement <input type="checkbox"/><br>Process Improvement <input type="checkbox"/><br>Manufacturing Process <input type="checkbox"/><br>Past Due <input type="checkbox"/> | Pressure/Forced <input type="checkbox"/><br>Bending <input type="checkbox"/><br>Centre Not Concentric <input type="checkbox"/><br>Cracks <input type="checkbox"/><br>Crimp/Kink/Ripple/Wave <input type="checkbox"/><br>Cuffs <input type="checkbox"/><br>Crushing <input type="checkbox"/><br>Heat Treat <input type="checkbox"/><br>Wave/Twist in Tube <input type="checkbox"/><br>Marks/Chatter <input type="checkbox"/> | Temperature/Cure <input type="checkbox"/><br>Set-up <input type="checkbox"/><br>BOM/Route <input type="checkbox"/><br>Broken/Damage/Defect <input type="checkbox"/><br>Inspection Incomplete/Unqualified <input type="checkbox"/><br>Contamination <input type="checkbox"/><br>Countersink <input type="checkbox"/><br>Cut Too Short <input type="checkbox"/><br>Instructions Incomplete/Unclear <input type="checkbox"/><br>Drill Holes <input type="checkbox"/> | Power Loss/Surge <input type="checkbox"/><br>Folio/Program <input type="checkbox"/><br>Grain <input type="checkbox"/><br>Weld <input type="checkbox"/><br>Wrong Stock Pulled <input type="checkbox"/><br>Out of Sequence <input type="checkbox"/><br>Off-set <input type="checkbox"/><br>Misabeled <input type="checkbox"/><br>Fit/Function <input type="checkbox"/><br>Misaligned/off center <input type="checkbox"/>   | Positioned Wrong <input type="checkbox"/><br>Outside Dimensions <input type="checkbox"/><br>Over/Under tolerance <input type="checkbox"/><br>Part Incorrect <input type="checkbox"/><br>Part Lost/Missing <input type="checkbox"/><br>Part Moved <input type="checkbox"/><br>Drawing <input type="checkbox"/><br>Finish <input type="checkbox"/><br>Misread <input type="checkbox"/><br>Turning Sequence <input type="checkbox"/> | OTHER : _____ |                       |                                                 |  |



DQA: \_\_\_\_\_ Date: \_\_\_\_\_



## WORK ORDER NON-CONFORMANCE / UPDATE

QA Closed: \_\_\_\_\_ Date: \_\_\_\_\_

Work Order update only ☐

|                                                              |                                                |   |                                                            |   |                                               |  |                       |                                              |  |
|--------------------------------------------------------------|------------------------------------------------|---|------------------------------------------------------------|---|-----------------------------------------------|--|-----------------------|----------------------------------------------|--|
| Work Order: _____<br><br>Part No. _____<br><br>NCR No. _____ |                                                | <b>DISPOSITION</b><br><br>Rework <input type="checkbox"/><br>Scrap <input type="checkbox"/><br>Use-as-is <input type="checkbox"/><br>Suspected Unapproved <input type="checkbox"/> |                                                            | <b>AGAINST DEPARTMENT/PROCESS</b><br><br><div style="display: flex; justify-content: space-between;"> <div>           Skid-tube <input type="checkbox"/><br/>           Machining <input type="checkbox"/><br/>           Thermoforming <input type="checkbox"/><br/>           Large Fab <input type="checkbox"/> </div> <div>           Cross tube <input type="checkbox"/><br/>           Small Fab <input type="checkbox"/><br/>           Finishing <input type="checkbox"/><br/>           Composite <input type="checkbox"/> </div> <div>           Water Jet <input type="checkbox"/><br/>           Prod. Eng. Coord. <input type="checkbox"/><br/>           Rec/Store/Packaging <input type="checkbox"/><br/>           Supplier <input type="checkbox"/> </div> <div>           Engineering <input type="checkbox"/><br/>           Quality <input type="checkbox"/><br/>           Other <input type="checkbox"/> </div> </div> |                                               |  |                       |                                              |  |
| Date : _____                                                 |                                                | Step #: _____   |                                                            | QTY Effective : _____   |                                               |  | MRB (QSI042) Approval |                                              |  |
| Description Work Order Deviation                             |                                                |   |                                                            | Disposition   |                                               |  |                       | Completed By                                 |  |
|                                                              |                                                |   |                                                            |   |                                               |  |                       | Lead hand / Supervisor Approval Verification |  |
|                                                              |                                                |   |                                                            |   |                                               |  |                       | QC / QA Coordinator Approval                 |  |
|                                                              |                                                |   |                                                            |   |                                               |  |                       |                                              |  |
| Root Cause                                                   |                                                | FAULT CATEGORY   |                                                            |   |                                               |  |                       |                                              |  |
| Environment <input type="checkbox"/>                         | No Re-verification <input type="checkbox"/>    | Pressure/Forced <input type="checkbox"/>   | Temperature/Cure <input type="checkbox"/>                  | Power Loss/Surge <input type="checkbox"/>   | Positioned Wrong <input type="checkbox"/>     |  |                       |                                              |  |
| Design <input type="checkbox"/>                              | Operator <input type="checkbox"/>              | Bending <input type="checkbox"/>   | Set-up <input type="checkbox"/>                            | Folio/Program <input type="checkbox"/>   | Outside Dimensions <input type="checkbox"/>   |  |                       |                                              |  |
| Doc/Data <input type="checkbox"/>                            | Offset/Setup <input type="checkbox"/>          | Centre Not Concentric <input type="checkbox"/>   | BOM/Route <input type="checkbox"/>                         | Grain <input type="checkbox"/>   | Over/Under tolerance <input type="checkbox"/> |  |                       |                                              |  |
| Equip/Tooling <input type="checkbox"/>                       | Supplier <input type="checkbox"/>              | Cracks <input type="checkbox"/>   | Broken/Damage/Defect <input type="checkbox"/>              | Weld <input type="checkbox"/>   | Part Incorrect <input type="checkbox"/>       |  |                       |                                              |  |
| Handling/Pre <input type="checkbox"/>                        | Training <input type="checkbox"/>              | Crimp/Kink/Ripple/Wave <input type="checkbox"/>   | Inspection Incomplete/Unqualified <input type="checkbox"/> | Wrong Stock Pulled <input type="checkbox"/>   | Part Lost/Missing <input type="checkbox"/>    |  |                       |                                              |  |
| Material <input type="checkbox"/>                            | Use for Testing <input type="checkbox"/>       | Cuffs <input type="checkbox"/>   | Contamination <input type="checkbox"/>                     | Out of Sequence <input type="checkbox"/>   | Part Moved <input type="checkbox"/>           |  |                       |                                              |  |
| Internal Transport <input type="checkbox"/>                  | Poor Information <input type="checkbox"/>      | Crushing <input type="checkbox"/>   | Countersink <input type="checkbox"/>                       | Off-set <input type="checkbox"/>   | Drawing <input type="checkbox"/>              |  |                       |                                              |  |
| Tribal Knowledge <input type="checkbox"/>                    | Rushing <input type="checkbox"/>               | Heat Treat <input type="checkbox"/>   | Cut Too Short <input type="checkbox"/>                     | Mislabeled <input type="checkbox"/>   | Finish <input type="checkbox"/>               |  |                       |                                              |  |
| LOA <input type="checkbox"/>                                 | Product Improvement <input type="checkbox"/>   | Wave/Twist in Tube <input type="checkbox"/>   | Instructions Incomplete/Unclear <input type="checkbox"/>   | Fit/Function <input type="checkbox"/>   | Misread <input type="checkbox"/>              |  |                       |                                              |  |
| Substation <input type="checkbox"/>                          | Process Improvement <input type="checkbox"/>   | Marks/Chatter <input type="checkbox"/>   | Drill Holes <input type="checkbox"/>                       | Misaligned/off center <input type="checkbox"/>   | Turning Sequence <input type="checkbox"/>     |  |                       |                                              |  |
| Past Expiry Date <input type="checkbox"/>                    | Manufacturing Process <input type="checkbox"/> | OTHER : _____   |                                                            |   |                                               |  |                       |                                              |  |
| Misidentified <input type="checkbox"/>                       | Past Due <input type="checkbox"/>              |   |                                                            |   |                                               |  |                       |                                              |  |

# Work Order ID 135113

**\*135113\***

Page 4

Item ID: D407-667-105TRN

Accept

**\*N900040100\***

Setup Start

**\*NS1\***

Revision ID:

Item Name: Crosstube Turning Detail

Stop

**\*NS2\***

Start Date: 7/29/2015 Start Qty: 1.00

**\*1\***

Cust Item ID:

Required Date: 8/12/2015 Req'd Qty: 1.00

**\*1\***

Customer:

Reference:

Approvals:

Process Plan: \_\_\_\_\_

Date: \_\_\_\_\_

Tooling: \_\_\_\_\_

Date: \_\_\_\_\_

Run Start

**\*NR1\***

QC: \_\_\_\_\_

Date: \_\_\_\_\_

SPC (Y/N): \_\_\_\_\_

Date: \_\_\_\_\_

Stop

**\*NR2\***

Sequence ID/  
Work Center ID

Operation  
Description

Set Up/  
Run Hours

Tool ID

Tool #

Plan  
Code

Accept  
Qty

Reject  
Qty

Reject  
Number

Insp.  
Stamp

160

QC5- Inspect part completeness to step on W/O

0.00

**\*160\***

QC

Memo

0.00

Quality Control

DAS

49

9-89

15/08/18

170

Packaging

0.00

**\*170\***

Packaging

Memo

0.00

Packaging

LOCATION: LG014

*Tu* 15-08-18

180

QC21- Final Inspection - Work Order Release

0.00

**\*180\***

QC

Memo

0.00

Quality Control

*ML*

AUG 18 2015

*ML*

AUG 18 2015

DQA: \_\_\_\_\_ Date: \_\_\_\_\_



## WORK ORDER NON-CONFORMANCE / UPDATE

QA Closed: \_\_\_\_\_ Date: \_\_\_\_\_

Work Order update only ☐

|   |  |   |  |   |  |   |                       |   |  |   |  |
|---|--|---|--|---|--|---|-----------------------|---|--|---|--|
| Work Order: _____<br><br>Part No. _____<br><br>NCR No. _____   |  | <b>DISPOSITION</b><br><br>Rework <input type="checkbox"/><br>Scrap <input type="checkbox"/><br>Use-as-is <input type="checkbox"/><br>Suspected Unapproved <input type="checkbox"/>   |  | <b>AGAINST DEPARTMENT/PROCESS</b><br><br><div style="display: flex; justify-content: space-between;"> <div>           Skid-tube <input type="checkbox"/><br/>           Machining <input type="checkbox"/><br/>           Thermoforming <input type="checkbox"/><br/>           Large Fab <input type="checkbox"/> </div> <div>           Cross tube <input type="checkbox"/><br/>           Small Fab <input type="checkbox"/><br/>           Finishing <input type="checkbox"/><br/>           Composite <input type="checkbox"/> </div> <div>           Water Jet <input type="checkbox"/><br/>           Prod. Eng. Coord. <input type="checkbox"/><br/>           Rec/Store/Packaging <input type="checkbox"/><br/>           Supplier <input type="checkbox"/> </div> <div>           Engineering <input type="checkbox"/><br/>           Quality <input type="checkbox"/><br/>           Other <input type="checkbox"/> </div> </div> |  |   |                       |   |  |   |  |
| Date :   |  | Step #:   |  | QTY Effective :   |  |   | MRB (QSI042) Approval |   |  |   |  |
| Description Work Order Deviation   |  |   |  | Disposition   |  |   |                       | Completed By   |  |   |  |
|   |  |   |  |   |  |   |                       |   |  |   |  |
|   |  |   |  |   |  |   |                       |   |  |   |  |
|   |  |   |  |   |  |   |                       |   |  |   |  |
| Root Cause   |  |   |  | FAULT CATEGORY   |  |   |                       |   |  |   |  |
| Environment <input type="checkbox"/><br>Design <input type="checkbox"/><br>Doc/Data <input type="checkbox"/><br>Equip/Tooling <input type="checkbox"/><br>Handling/Pre <input type="checkbox"/><br>Material <input type="checkbox"/><br>Internal Transport <input type="checkbox"/><br>Tribal Knowledge <input type="checkbox"/><br>LOA <input type="checkbox"/><br>Substation <input type="checkbox"/><br>Past Expiry Date <input type="checkbox"/><br>Misidentified <input type="checkbox"/> |  | No Re-verification <input type="checkbox"/><br>Operator <input type="checkbox"/><br>Offset/Setup <input type="checkbox"/><br>Supplier <input type="checkbox"/><br>Training <input type="checkbox"/><br>Use for Testing <input type="checkbox"/><br>Poor Information <input type="checkbox"/><br>Rushing <input type="checkbox"/><br>Product Improvement <input type="checkbox"/><br>Process Improvement <input type="checkbox"/><br>Manufacturing Process <input type="checkbox"/><br>Past Due <input type="checkbox"/> |  | Pressure/Forced <input type="checkbox"/><br>Bending <input type="checkbox"/><br>Centre Not Concentric <input type="checkbox"/><br>Cracks <input type="checkbox"/><br>Crimp/Kink/Ripple/Wave <input type="checkbox"/><br>Cuffs <input type="checkbox"/><br>Crushing <input type="checkbox"/><br>Heat Treat <input type="checkbox"/><br>Wave/Twist in Tube <input type="checkbox"/><br>Marks/Chatter <input type="checkbox"/>   |  | Temperature/Cure <input type="checkbox"/><br>Set-up <input type="checkbox"/><br>BOM/Route <input type="checkbox"/><br>Broken/Damage/Defect <input type="checkbox"/><br>Inspection Incomplete/Unqualified <input type="checkbox"/><br>Contamination <input type="checkbox"/><br>Countersink <input type="checkbox"/><br>Cut Too Short <input type="checkbox"/><br>Instructions Incomplete/Unclear <input type="checkbox"/><br>Drill Holes <input type="checkbox"/> |                       | Power Loss/Surge <input type="checkbox"/><br>Folio/Program <input type="checkbox"/><br>Grain <input type="checkbox"/><br>Weld <input type="checkbox"/><br>Wrong Stock Pulled <input type="checkbox"/><br>Out of Sequence <input type="checkbox"/><br>Off-set <input type="checkbox"/><br>Misabeled <input type="checkbox"/><br>Fit/Function <input type="checkbox"/><br>Misaligned/off center <input type="checkbox"/> |  | Positioned Wrong <input type="checkbox"/><br>Outside Dimensions <input type="checkbox"/><br>Over/Under tolerance <input type="checkbox"/><br>Part Incorrect <input type="checkbox"/><br>Part Lost/Missing <input type="checkbox"/><br>Part Moved <input type="checkbox"/><br>Drawing <input type="checkbox"/><br>Finish <input type="checkbox"/><br>Misread <input type="checkbox"/><br>Turning Sequence <input type="checkbox"/> |  |
| <div style="display: flex; justify-content: space-between;"> <span>OTHER :</span> <span></span> </div>   |  |   |  |   |  |   |                       |   |  |   |  |



# Picklist Print

July 29, 2015 11:00:53 AM

Page 1

Work Order ID: 135113

**\*135113\***

Parent Item: D407-667-105TRN

**\*D407-667-105TRN\***

Parent Item Name: Crosstube Turning Detail

Start Date: 7/29/2015

Required Date: 8/12/2015

Start Qty: 1.00

Required Qty: 1.00

Comments: IPP Rev:a08.02.28 new issueEC  
IPP Rev B 08.04.02 Removed polish EC verified by: DD

| Component Item ID/<br>Item Name | Replacement<br>Item ID | Mfg/<br>Purch | Bin<br>Item | Primary<br>Location | Last<br>Location | Route<br>Seq ID | Unit of<br>Measure | Qty on<br>Hand | Qty per Kit | Total<br>Qty | Qty<br>Issued | Date<br>Issued | Status |
|---------------------------------|------------------------|---------------|-------------|---------------------|------------------|-----------------|--------------------|----------------|-------------|--------------|---------------|----------------|--------|
| D6010-115                       |                        | Manufactured  | No          |                     |                  | 110             | Each               | 22.0000        | 1           | 1            |               |                |        |

**\*D6010-115\***

**\*\***

Crosstube Material

Location

Loc Qty

Loc Code

LG003

22

107878

22

1 mm l 15/07/30

| Item | Qty<br>-145 | Part Number       | Description   |
|------|-------------|-------------------|---|
| 1    | X           | D407-667-145      | CROSSTUBE ASSEMBLY (407 HIGH FWD)                                                                              |
| 2    | 1           | D6010-115         | CROSSTUBE   |
| 3    | 2           | D2873-043         | NUT PLATE   |
| 4    | 2           | D2873-045         | NUT PLATE   |
| 5    | 2           | D2891-1           | SUPPORT   |
| 6    | 4           | D3595-063-395     | RUBBER CUSHION                                                                                                 |
| 7    | 4           | MS21920-20        | CLAMP (OR MS21920-21)                                                                                          |
| 8    | 14          | MS20601AD4W10     | RIVET (OR NAS9302B-4-10)                                                                                       |
| 9    | A/R         | MAGNOBOND<br>6398 | ROCKWELL SPECIFICATION RBO-120-023<br>ADHESIVE (TEXTRON/BELL SPEC. 299-<br>947-100, TYPE II, CLASS 2 ADHESIVE) |

#### GENERAL NOTES:

- 1) MATERIAL: MANUFACTURED FROM D6010-115  
FINISHED LENGTH = 113.20±0.020
- 2) FINISH: CHEMICAL CONVERSION COAT PER DART QSI 005 4.1  
PRIME INSIDE AND OUTSIDE PER DART QSI 005 4.2  
PAINT OUTSIDE PER DART QSI 005 4.2
- 3) TOLERANCES ARE PER DART QSI 018 UNLESS OTHERWISE NOTED.
- 4) UNITS: INCHES UNLESS OTHERWISE NOTED.
- 5) BREAK SHARP EDGES: 0.005 TO 0.010 MAX.
- 6) IDENTIFICATION: SCRIBE DART PART NUMBER "D407-667-145" AND BATCH NUMBER ON  
INSIDE OF CUFF USING VIBRATING STYLUS.
- 7) WEIGHT: 17.8 lbs
- 8) PART IS SYMMETRIC ABOUT CENTERLINE.
- 9) RUN CUTTER OFF PART WHERE INDICATED. BLEND OUT EDGE LONGITUDINALLY,  
TRANSITION SHOULD BE SMOOTH.
- 10) BEND PROGRESSIVELY WITH A MINIMUM OF 6 PASSES. MAXIMUM TUBE FLATTENING DUE  
TO BENDING IS 6% BASED ON O.D.
- 11) LIQUID PENETRANT INSPECT OUTSIDE SURFACE OF CROSSTUBE PER QSI 038.
- 12) INSTALL D2891-1 SUPPORT USING 0.03" TO 0.06" THICK LAYER OF MAGNOBOND 6398 PER  
QSI 015. LET CURE FOR 12 HOURS AFTER INSTALLATION AND PRIOR TO PACKAGING.
- 13) INSTALL MS21920-20 CLAMPS (OR -21) WITH D3595-063-395 RUBBER CUSHIONS TO SECURE  
THE D2891-1 SUPPORT ON TOP SIDE OF THE CROSSTUBE. ENSURE CLAMP MECHANISMS  
ARE LOCATED ON CROSSTUBE SUPPORTS.
- 14) EXTREME CARE MUST BE TAKEN TO PROTECT THE OUTSIDE SURFACE OF THE TUBE. THE  
OUTSIDE SURFACE MUST BE SMOOTH AND FREE FROM SURFACE DEFECTS SUCH AS  
SCRATCHES, NICKS, OR DENTS. DEFECTS UP TO 0.005" MAY BE BLENDED OUT  
LONGITUDINALLY. CIRCUMFERENTIAL GRIND MARKS ARE UNACCEPTABLE.
- 15) TORQUE CLAMPS 80 TO 100 IN-LB. ENSURE AT LEAST 1.5 THREADS ARE SHOWING IN  
SAFETY AND THAT NUT HAS NOT BOTTOMED-OUT AFTER TORQUING.

DEO ATTACHED

ECW#11-615  
11.07.26


UNDER REVIEW

RELEASED  
03/11/12

135113  
84 20150729


|            |   |                                                   |          |
|------------|---|---------------------------------------------------|----------|
| C          | REVISE GENERAL NOTES/PART LIST (ZN D7-1);<br>REORGANIZED VIEWS AND REFORMATTED DRAWING<br>TO CURRENT STANDARDS.<br>D3595-063-395 WAS D2856-400-694 (ZN D6-2 & A5-2);<br>REMOVED REF. 7 ADD TOLERANCES (ZN C6-3, C4-3,<br>D2-3); RELOCATED FLAG #6 (ZN A8-3) PER NCR 210;<br>MOVED TURNING DETAIL & UPDATED TOLERANCE TO<br>SHEET 4. | RF                                                | 08.11.06 |
| B          | ADD HOLES AND NUT PLATES FOR COMPATABILITY<br>WITH BHT/AA SKUDTUBES   | PH                                                | 05.07.26 |
| A          | NEW ISSUE   | CP                                                | 02.05.08 |
| REV.       | DESCRIPTION   | BY                                                | DATE     |
| DESIGN     | RF   | DART AEROSPACE LTD<br>HAWKESBURY, ONTARIO, CANADA |          |
| DRAWN      | RF   | REV. C                                            |          |
| CHECKED    | RF   | DRAWING NO. D407-667-145 SHEET 1 OF 4             |          |
| MFG. APPR. | RF   | SCALE                                             |          |
| APPROVED   | RF   | TITLE CROSSTUBE ASS'Y (407 HIGH FWD) NTS          |          |
| DE APPR.   | RF   | DATE 08.11.06                                     |          |

COPYRIGHT © 2002 BY DART AEROSPACE LTD  
THIS DOCUMENT IS PRIVATE AND CONFIDENTIAL AND IS SUPPLIED ON THE EXPRESS CONDITION THAT IT IS  
NOT TO BE USED FOR ANY PURPOSE OR COPIED OR COMMUNICATED TO ANY OTHER PERSON WITHOUT  
WRITTEN PERMISSION FROM DART AEROSPACE LTD.

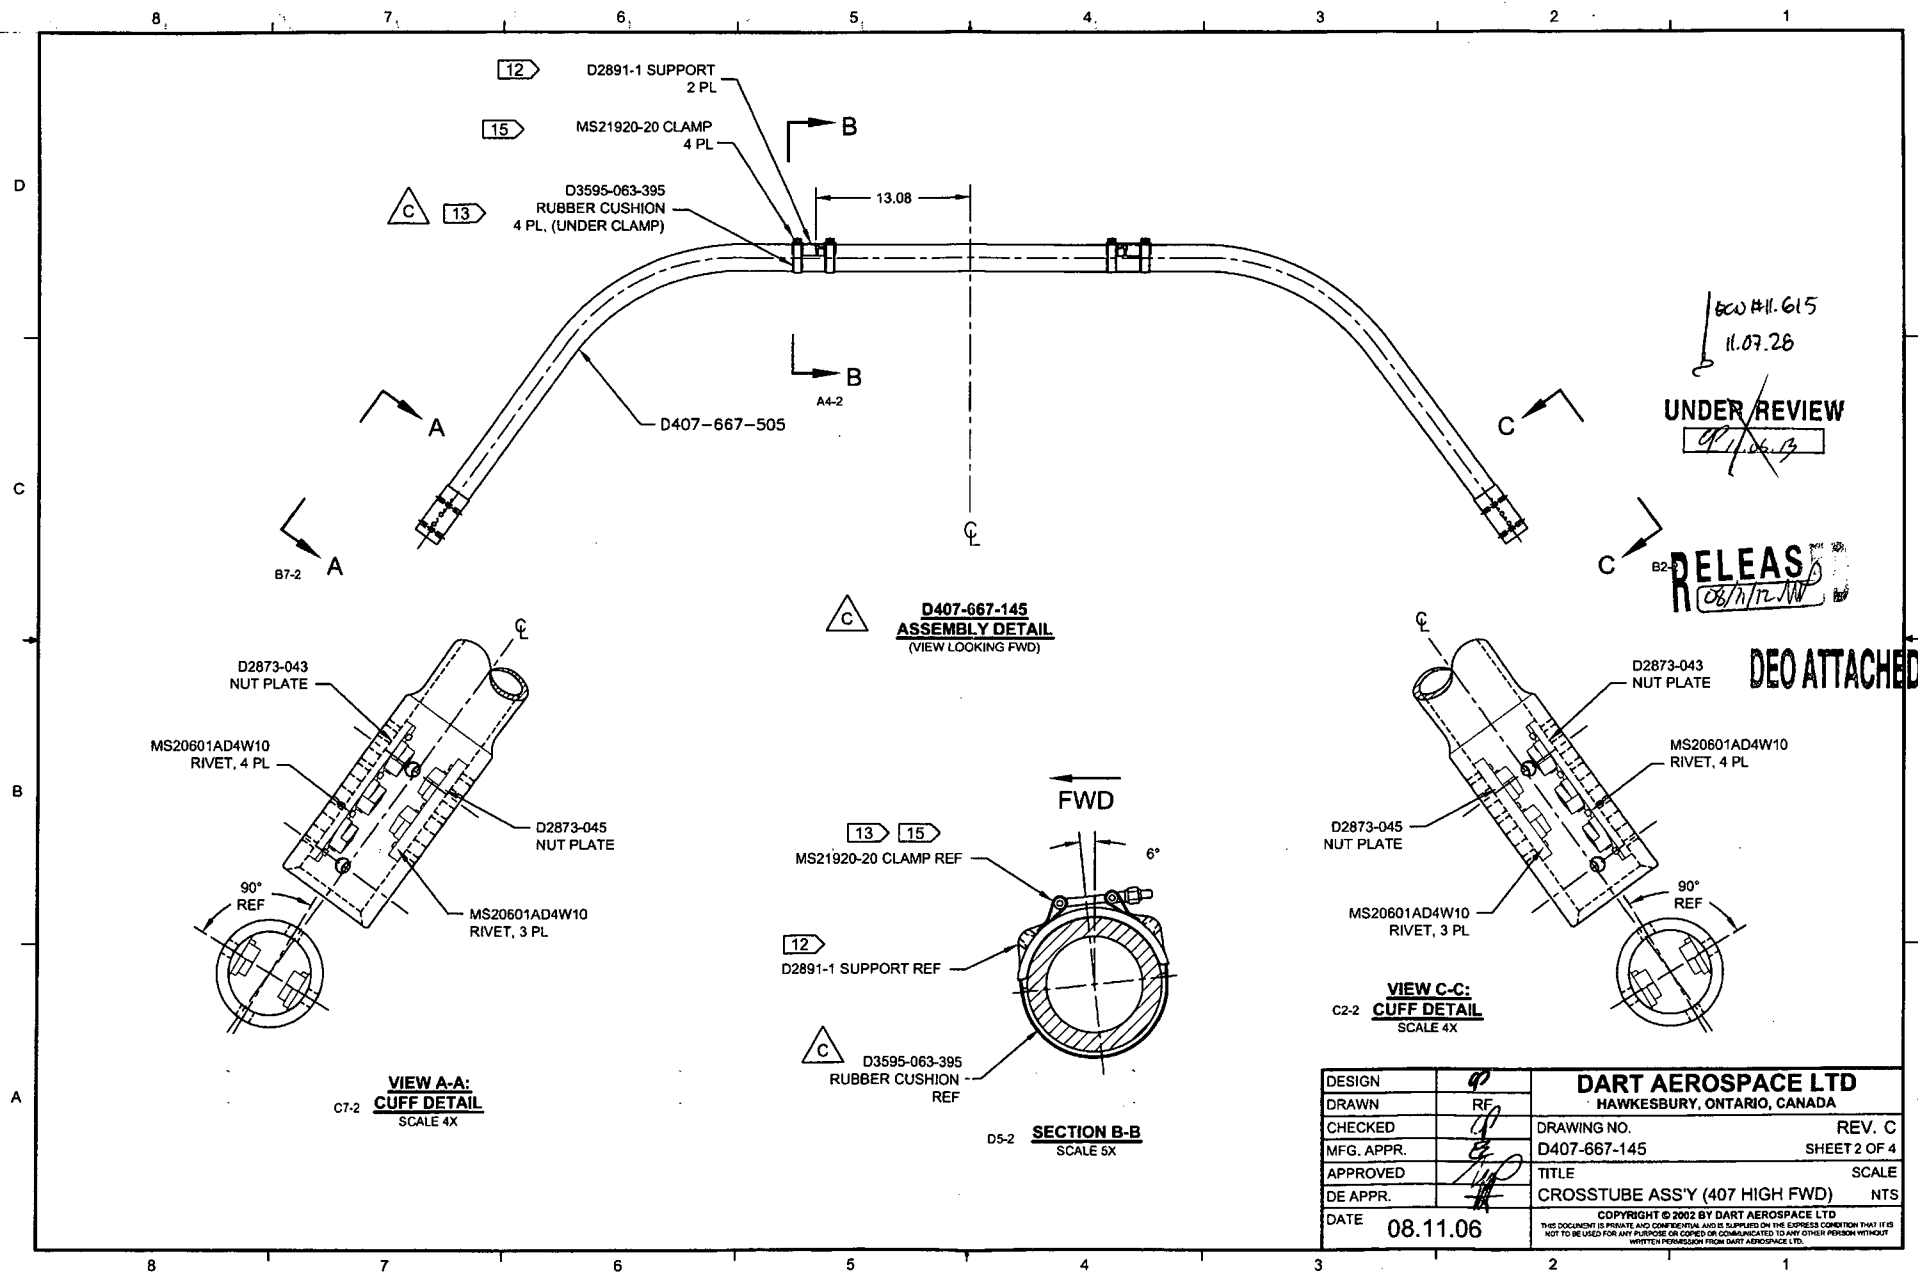

|            |          |   |              |
|------------|----------|---|--------------|
| DESIGN     | 90       | <b>DART AEROSPACE LTD</b>   |              |
| DRAWN      | RF       | HAWKESBURY, ONTARIO, CANADA   |              |
| CHECKED    | RF       | DRAWING NO.   | REV. C       |
| MFG. APPR. | RF       | D407-667-145   | SHEET 2 OF 4 |
| APPROVED   | RF       | TITLE   | SCALE        |
| DE APPR.   | RF       | CROSSTUBE ASSY (407 HIGH FWD)   | NTS          |
| DATE       | 08.11.06 | <small>COPYRIGHT © 2002 BY DART AEROSPACE LTD<br/>THIS DOCUMENT IS PRIVATE AND CONFIDENTIAL AND IS SUPPLIED ON THE EXPRESS CONDITION THAT IT IS NOT TO BE USED FOR ANY PURPOSE OR COMMUNICATED TO ANY OTHER PERSON WITHOUT WRITTEN PERMISSION FROM DART AEROSPACE LTD.</small> |              |




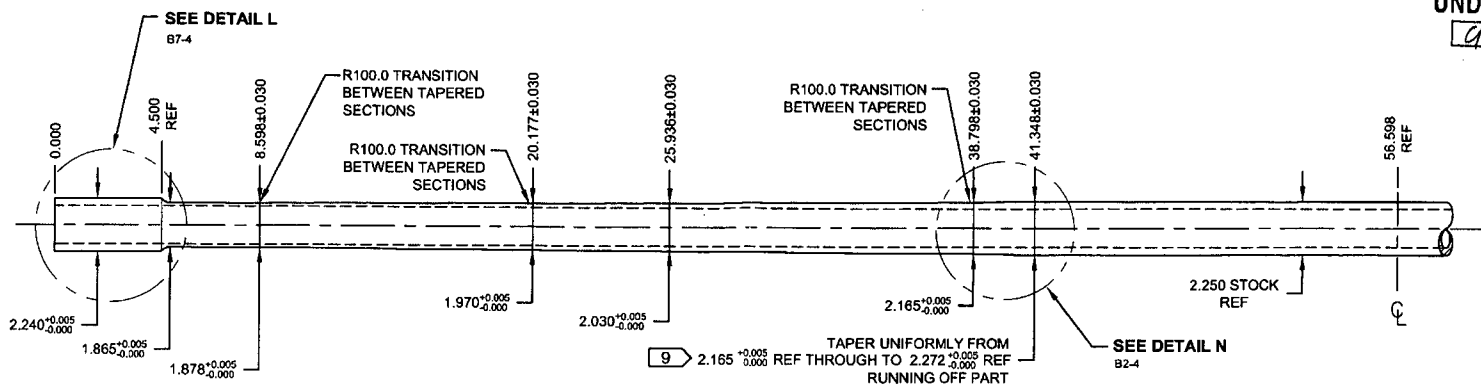


**UNDER REVIEW**

CP 11.08.13  
B2-4 H. 615  
11.07.26


**C TURNING DETAIL**

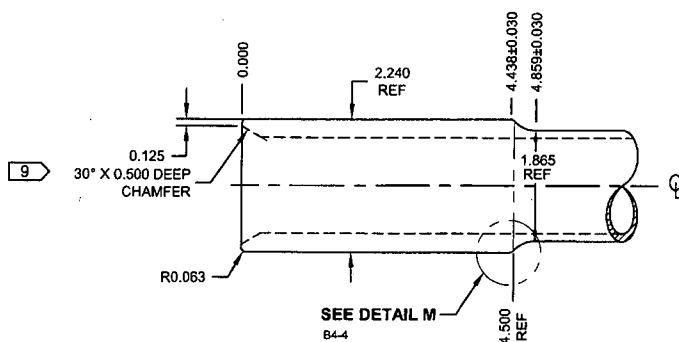

**DETAIL L:  
CROSSTUBE CUFF**  
D7-4 NOT TO SCALE

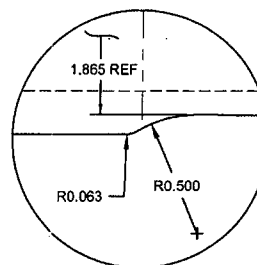

**DETAIL M:  
CUFF TRANSITION**  
B6-4 NOT TO SCALE

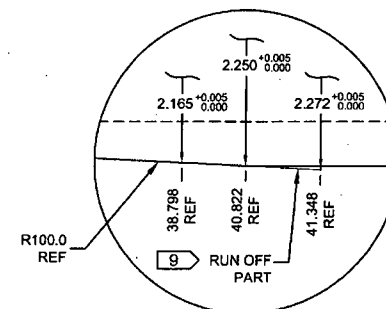

**DETAIL N:  
TAPER RUN-OFF**  
C3-4 NOT TO SCALE

**DEO ATTACHED**

**RELEASED**  
08/11/2007

|            |          |   |              |
|------------|----------|---|--------------|
| DESIGN     | 90       | <b>DART AEROSPACE LTD</b>   |              |
| DRAWN      | RF       | HAWKESBURY, ONTARIO, CANADA   |              |
| CHECKED    | CP       | DRAWING NO.   | REV. C       |
| MFG. APPR. | CP       | D407-667-145   | SHEET 4 OF 4 |
| APPROVED   | CP       | TITLE   | SCALE        |
| DE APPR.   | CP       | CROSSTUBE ASS'Y (407 HIGH FWD)   | NTS          |
| DATE       | 08.11.06 | COPYRIGHT © 2002 BY DART AEROSPACE LTD<br>THIS DOCUMENT IS PRIVATE AND CONFIDENTIAL AND IS SUPPLIED ON THE EXPRESS CONDITION THAT IT IS NOT TO BE USED FOR ANY PURPOSE OR COPIED OR COMMUNICATED TO ANY OTHER PERSON WITHOUT WRITTEN PERMISSION FROM DART AEROSPACE LTD. |              |

|                             |                                         |                   |                                         |  |                                |                           |              |
|-----------------------------|-----------------------------------------|-------------------|-----------------------------------------|--|--------------------------------|---------------------------|--------------|
| DRAWING NO.<br>D407-667-145 | TITLE<br>CROSSTUBE ASS'Y (407 HIGH FWD) | REV. C            | DART AEROSPACE LTD<br>ENGINEERING ORDER |  | D.E.O. NO.<br>D407-667-145-C-1 | SHEET NO.<br>SHEET 1 OF 1 | SCALE<br>NTS |
| DRAWN<br>40                 | CHECKED<br>ASS                          | MFG. APPR.<br>188 | APPROVED<br>WD                          |  | DE APPR.<br>H                  |                           |              |
| DATE<br>11.07.15            | DATE<br>11.07.22                        | DATE<br>11.07.22  | DATE<br>11/07/22                        |  | DATE<br>11.07.21               |                           |              |

**PURPOSE:**

REPLACE MAGNOBOND WITH PROSEAL.

**CHANGE:**

IS:

| Item | Qty<br>-145 | Part Number     | Description                   |
|------|-------------|-----------------|-------------------------------|
| 9    | A/R         | PROSEAL 890 B-2 | SEALANT, AMS-S-8802 CLASS B-2 |

WAS:

|   |     |                |   |
|---|-----|----------------|---|
| 9 | A/R | MAGNOBOND 6398 | ROCKWELL SPECIFICATION RBO-120-023<br>ADHESIVE (TEXTRON/BELL SPEC. 299-947-100,<br>TYPE II, CLASS 2 ADHESIVE) |
|---|-----|----------------|---|

NOTE 12 & 15, SHEET 1 IS AMENDED AS FOLLOWS:

IS:

- 12) TO INSTALL D2891-1 SUPPORT: ABRABE MATING SURFACE OF SUPPORT AND CROSSTUBE WITH 180-GRIT SANDPAPER AND REMOVE RESIDUE WITH MEK (OR EQUIVALENT). APPLY A 0.04" TO 0.07" THICK LAYER OF PROSEAL 890 CLASS B-2 (OR AMS-S-8802 CLASS B-2) SEALANT TO MATING SURFACE OF SUPPORT.
- 15) TORQUE CLAMPS 80 TO 100 IN-LB. ENSURE AT LEAST 1.5 THREADS SHOWING IN SAFETY AND THAT NUT HAS NOT BOTTOMED-OUT AFTER TORQUING. **PRIOR TO PACKAGING, RE-CHECK TORQUE ON CLAMPS AFTER PROSEAL 890 SEALANT HAS CURED FOR 72 HOURS.**

WAS:

- 12) INSTALL D2891-1 SUPPORT USING 0.03" TO 0.06" THICK LAYER OF MAGNOBOND 6398 PER QSI 015. LET CURE FOR 12 HOURS AFTER INSTALLATION AND PRIOR TO PACKAGING.
- 15) TORQUE CLAMPS 80 TO 100 IN-LB. ENSURE AT LEAST 1.5 THREADS SHOWING IN SAFETY AND THAT NUT HAS NOT BOTTOMED-OUT AFTER TORQUING.

**RELEASED**  
2011-07-28  
WD

|                             |                                         |                           |                                                 |                                |                           |              |
|-----------------------------|-----------------------------------------|---------------------------|-------------------------------------------------|--------------------------------|---------------------------|--------------|
| DRAWING NO.<br>D407-667-145 | TITLE<br>CROSSTUBE ASS'Y (407 HIGH FWD) | REV. C                    | <b>DART AEROSPACE LTD<br/>ENGINEERING ORDER</b> | D.E.O. NO.<br>D407-667-145-C-2 | SHEET NO.<br>SHEET 1 OF 1 | SCALE<br>NTS |
| DRAWN<br>AJS                | CHECKED<br>[Signature]                  | MFG. APPR.<br>[Signature] | APPROVED<br>[Signature]                         | DE APPR.<br>[Signature]        |                           |              |
| DATE<br>12.08.02            | DATE<br>12.08.02                        | DATE<br>12.08.02          | DATE<br>12.08.02                                | DATE<br>12.08.02               | DATE<br>12.08.02          |              |

**PURPOSE:**

ADD ELECTRICAL GROUNDING STRAP


**CHANGE:**

| ITEM | QTY<br>-145 | PART NUMBER   | DESCRIPTION                       |       |
|------|-------------|---------------|-----------------------------------|-------|
| 1    | X           | D407-667-145  | CROSSTUBE ASSEMBLY (407 HIGH FWD) |       |
|      |             |               |                                   |       |
| 10   | 2           | AN742D36      | CLAMP                             | } ADD |
| 11   | 2           | MS9165-05     | ANGLE BRACKET                     |       |
| 12   | 2           | MS21042L3     | NUT (OR MS21042-3)                |       |
| 13   | 2           | MS27039-1-08  | SCREW                             |       |
| 14   | 4           | NAS1149C0332R | WASHER (OR AN960C10L)             |       |

**GENERAL NOTES:**

- 16) MASK AREA UNDER CLAMP PRIOR TO PAINTING
- 17) SEAL EDGES WHERE AN742D36 CLAMP MEETS WITH THE CROSSTUBE USING SIKAFLEX-241/-291 OR MIL-S-8802 CLASS B2 OR PROSEAL 890 SEALANT
- 18) PERFORM RESISTANCE CHECK TO ENSURE MAX RESISTANCE IS 10 MILLIOHMS

**RELEASED**  
CP 12.08.17  
ECN 12-631

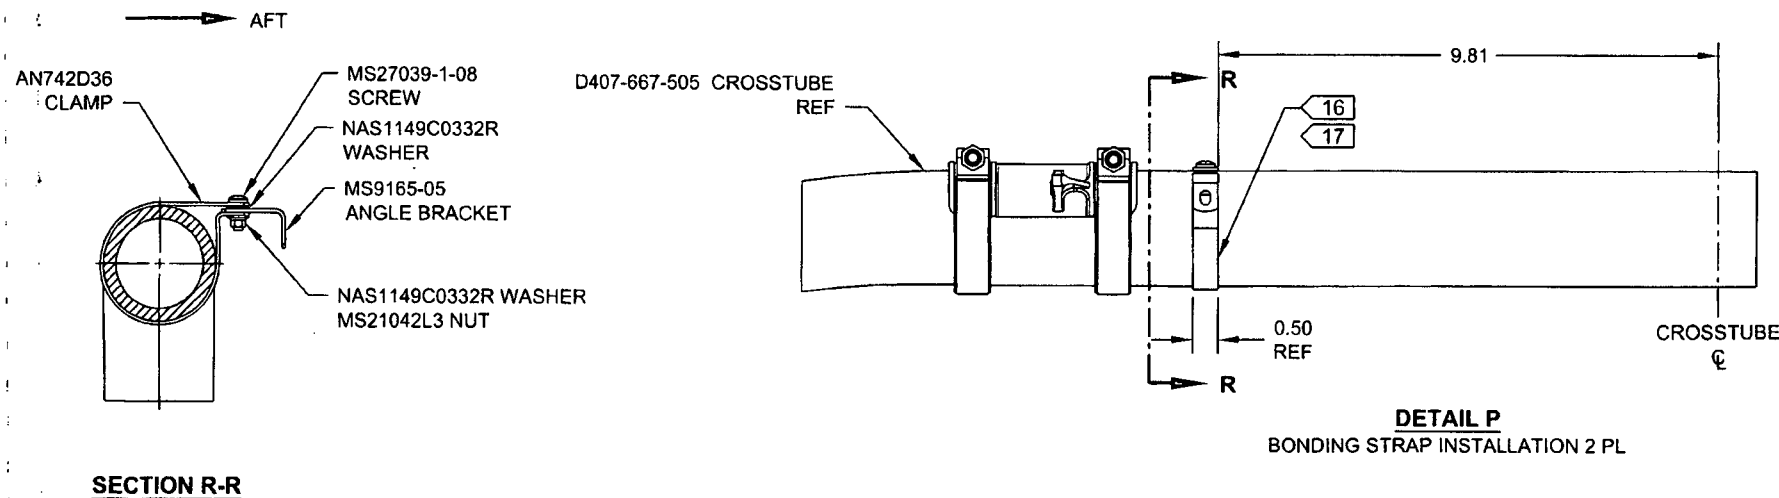

|                                            |  |                                  |
|--------------------------------------------|--|----------------------------------|
| <b>DART AEROSPACE LTD</b>                  |  | <b>Work Order:</b> 135113        |
| <b>Description:</b> Crosstube Assembly     |  | <b>Part Number:</b> D407-667-145 |
| <b>Inspection Dwg:</b> D407-667-145 Rev: C |  | <b>Page 1 of 2</b>               |


### FIRST ARTICLE INSPECTION CHECKLIST

|        | Inspection Sheet<br>Drawing Dimension | Tolerance     | Actual<br>Dimension | Accept | Reject | Method of<br>Inspection | Comments |
|--------|---------------------------------------|---------------|---------------------|--------|--------|-------------------------|----------|
| SIDE A | 2.240                                 | +0.005/-0.000 | 2.244               | ✓      |        | vern                    | CNC-08   |
|        | 1.865                                 | +0.005/-0.000 | 1.870               | ✓      |        |                         |          |
|        | 1.878                                 | +0.005/-0.000 | 1.881               | ✓      |        |                         |          |
|        | 1.970                                 | +0.005/-0.000 | 1.974               | ✓      |        |                         |          |
|        | 2.030                                 | +0.005/-0.000 | 2.034               | ✓      |        |                         |          |
|        | 2.165                                 | +0.005/-0.000 | 2.167               | ✓      |        |                         |          |
|        |                                       |               |                     |        |        |                         |          |
|        | 0.125                                 | +/-0.010      | .125                | ✓      |        | vern                    | CNC-08   |
|        | R0.063                                | +/-0.010      | .063                | ✓      |        | RG                      |          |
|        | R0.500                                | +/-0.010      | .500                | ✓      |        | II                      |          |
|        | R0.063                                | +/-0.010      | .063                | ✓      |        | II                      |          |
|        | 4.438                                 | +/-0.030      | 4.440               | ✓      |        | vern                    | CNC-08   |
| SIDE B | 2.240                                 | +0.005/-0.000 | 2.243               | ✓      |        | vern                    | CNC-08   |
|        | 1.865                                 | +0.005/-0.000 | 1.870               | ✓      |        |                         |          |
|        | 1.878                                 | +0.005/-0.000 | 1.882               | ✓      |        |                         |          |
|        | 1.970                                 | +0.005/-0.000 | 1.973               | ✓      |        |                         |          |
|        | 2.030                                 | +0.005/-0.000 | 2.035               | ✓      |        |                         |          |
|        | 2.165                                 | +0.005/-0.000 | 2.167               | ✓      |        |                         |          |
|        |                                       |               |                     |        |        |                         |          |
|        | 0.125                                 | +/-0.010      | .125                | ✓      |        | vern                    | CNC-08   |
|        | R0.063                                | +/-0.010      | .063                | ✓      |        | RG                      |          |
|        | R0.500                                | +/-0.010      | .500                | ✓      |        | II                      |          |
|        | R0.063                                | +/-0.010      | .063                | ✓      |        | II                      |          |
|        | 4.438                                 | +/-0.030      | 4.440               | ✓      |        | vern                    | CNC-08   |
|        | 113.20                                | +/-0.020      | 113.20              | ✓      |        | thpc                    | FG-11    |



|                                            |  |                                  |
|--------------------------------------------|--|----------------------------------|
| <b>DART AEROSPACE LTD</b>                  |  | <b>Work Order:</b> 135113        |
| <b>Description:</b> Crosstube Assembly     |  | <b>Part Number:</b> D407-667-145 |
| <b>Inspection Dwg:</b> D407-667-145 Rev: C |  | <b>Page 2 of 2</b>               |

### WALL THICKNESS MEASUREMENT

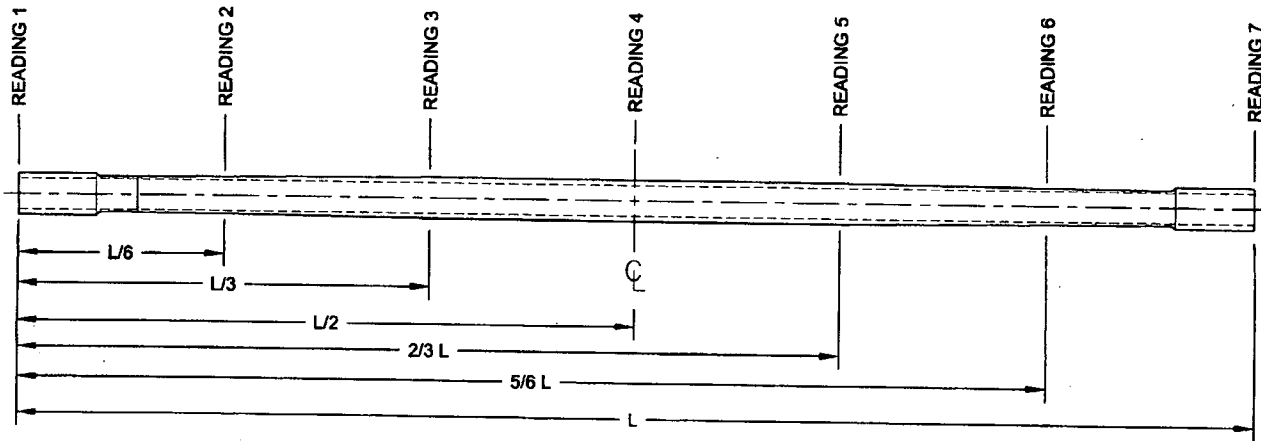

| Location            | WALL THICKNESS MEASUREMENT (IN) |      |      |      | Deviation<br>$\Delta w$<br>(max-min) | TOLERANCE |
|---------------------|---------------------------------|------|------|------|--------------------------------------|-----------|
|                     | w1                              | w2   | w3   | w4   |                                      |           |
| READING 1<br>L= 0"  | .337                            | .330 | .302 | .312 | .035                                 | 0.042"    |
| READING 2<br>L= 19  | .190                            | .180 | .168 | .177 | .022                                 |           |
| READING 3<br>L= 38  | .246                            | .277 | .257 | .265 | .031                                 |           |
| READING 4<br>L= 57  | .339                            | .326 | .304 | .308 | .035                                 |           |
| READING 5<br>L= 76  | .281                            | .277 | .252 | .258 | .037                                 |           |
| READING 6<br>L= 95  | .193                            | .185 | .160 | .164 | .033                                 |           |
| READING 7<br>L= 113 | .335                            | .331 | .304 | .305 | .031                                 |           |

#### Calibration Result

Actual Block Thickness: ~~100~~ .750

Sitiescan 250 Measured Thickness: ~~100~~ .250

|                     |          |
|---------------------|----------|
| <b>Measured by:</b> | anm/l    |
| <b>Date:</b>        | 15/08/05 |

|                    |           |
|--------------------|-----------|
| <b>Audited by:</b> | DAS<br>47 |
| <b>Date:</b>       | 15-08-10  |

|                              |  |
|------------------------------|--|
| <b>Preliminary Approval:</b> |  |
| <b>Date:</b>                 |  |

| Rev | Date     | Change                                | Revised by | Approved |
|-----|----------|---------------------------------------|------------|----------|
| A   | 04.04.21 | New Issue (P/O D407-667-105)          | KJ/RF      |          |
| B   | 06.03.09 | Dwg Rev updated                       | KJ/JLM     |          |
| C   | 09.06.11 | Dwg Rev updated                       | KJ         |          |
| D   | 11.06.21 | Tolerance revised for 4.438 dimension | KJ         |          |
| E   | 12.06.04 | Wall thickness form added             | KJ         |          |

